


TANK GULCH AS-BUILT CONTOURS  
SEPTEMBER 1993

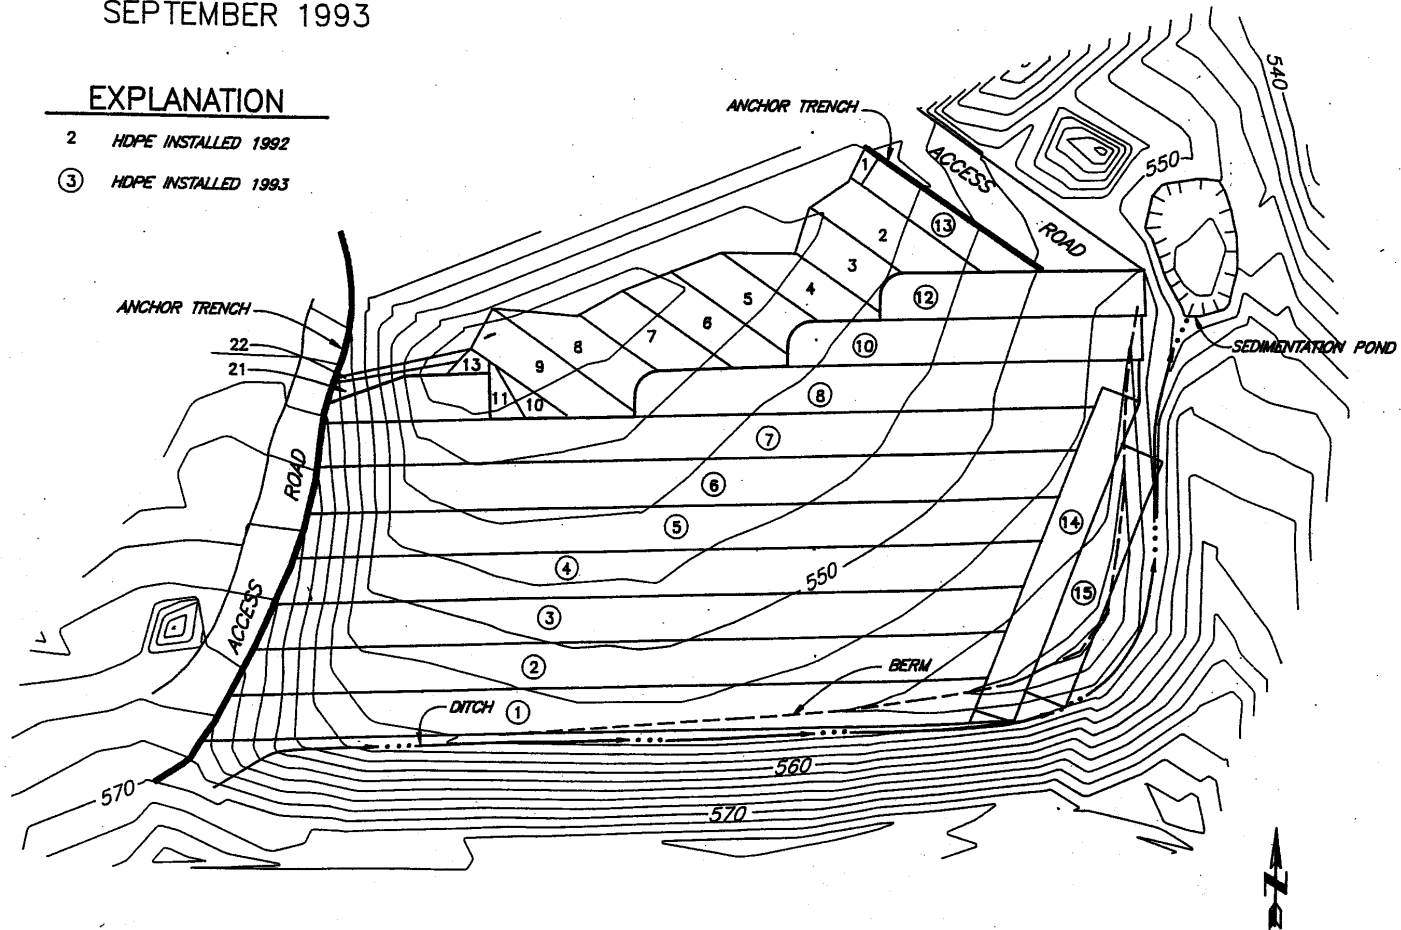

Attachment D  
As-Built of Phase I Liner  
Pacific Lumber Company Tank Gulch

Source: SHN Consulting Engineers & Geologists, Inc.  
CQA Report, October 1993